


DO NOT SCALE

A1
 0 10 100

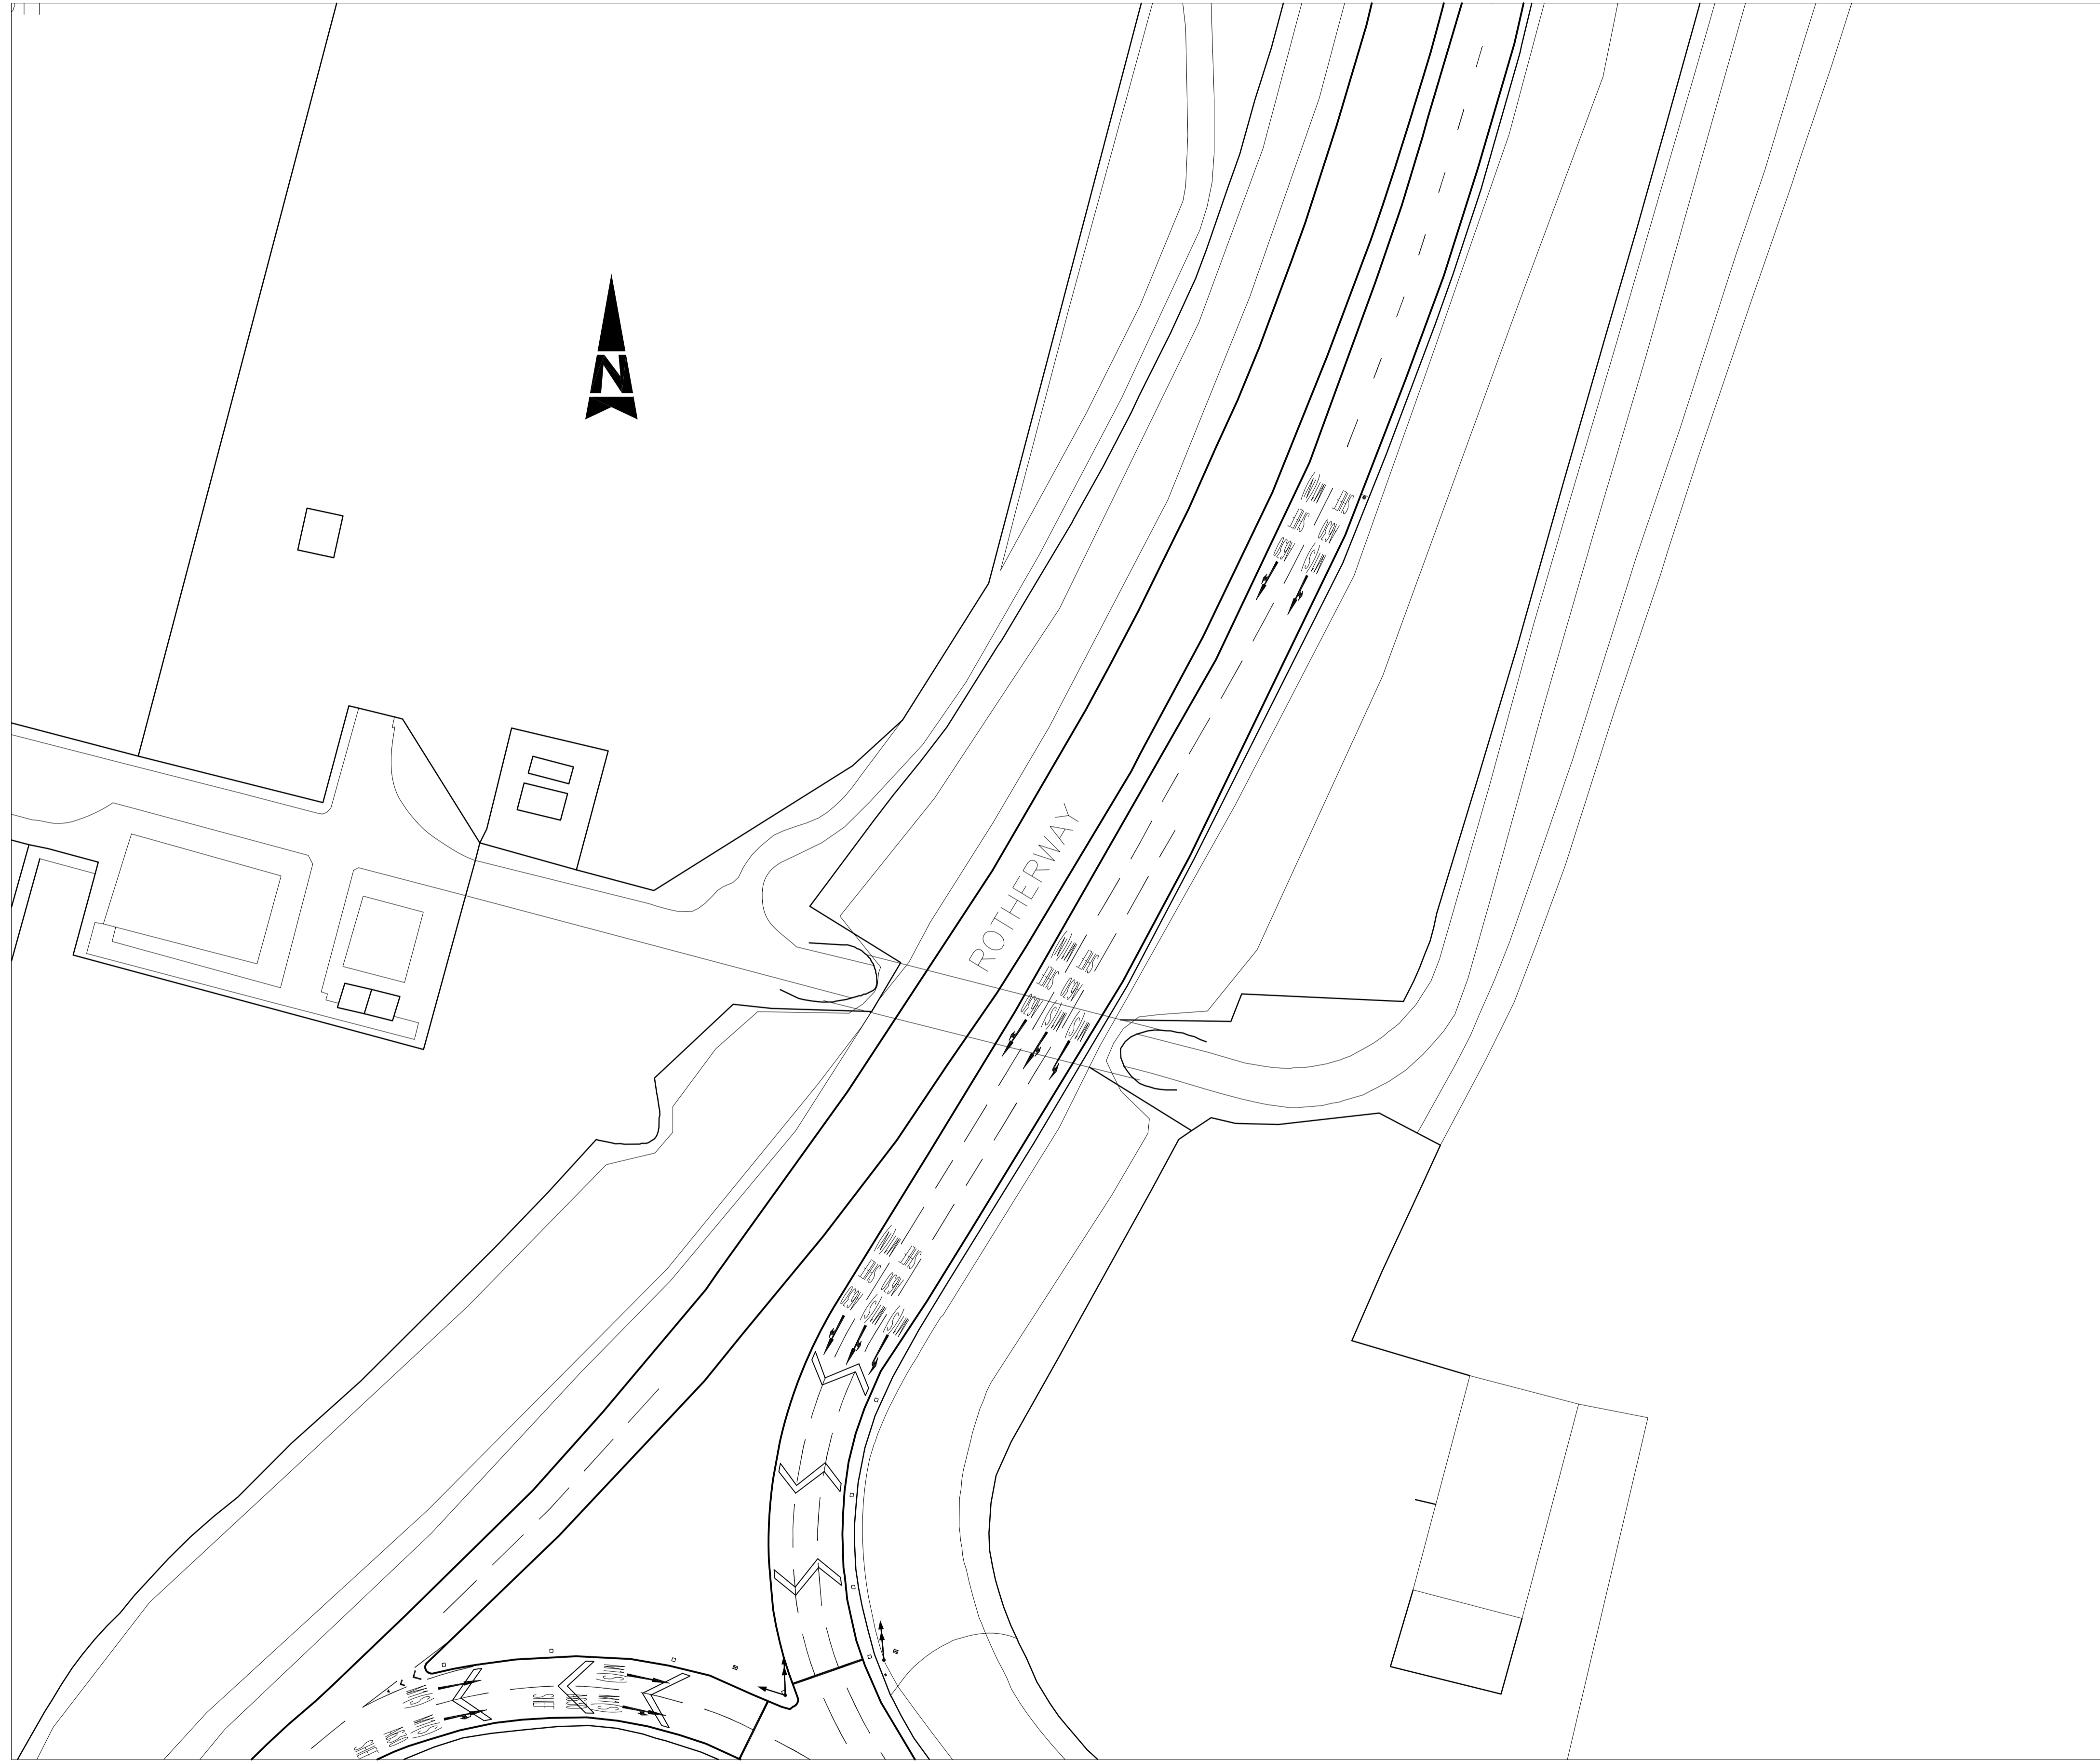


SAFETY, HEALTH AND ENVIRONMENTAL INFORMATION			
IN ADDITION TO THE HAZARDS/RISKS NORMALLY ASSOCIATED WITH THE TYPES OF WORK DETAILED ON THIS DRAWING, NOTE THE FOLLOWING SIGNIFICANT RESIDUAL RISKS			
CONSTRUCTION	[ENTER 'NONE' IF APPLICABLE]		
MAINTENANCE/CLEANING	[ENTER 'NONE' IF APPLICABLE]		
USE	[ENTER 'NONE' IF APPLICABLE]		
DECOMMISSIONING/DEMOLITION	[ENTER 'NONE' IF APPLICABLE]		

Stat	Purpose of Issue	Date	Auth	Rev	Description	By	Date	Chk'd	Auth
A	ORIGINAL ISSUE	17/12/07	ADF	LS					

ATKINSTM
Atkins Limited
 Consulting Engineers,
 Threadneedle House,
 9-10 Market Road,
 Chelmsford, Essex, England,
 CM1 1XA

Tel: (01245) 245245
 Fax: (01245) 345010
 www.atkinsglobal.com

Client

HIGHWAYS AGENCY

Project
 M1J33
 ITM PROJECT

PROPOSED ROAD MARKINGS				
Sheet Size	Original Scale	Designed/Drawn	Checked	Authorized
A1	1:500	DM	ADF	LS
Status	Drawing Number	Date	Date	Date
P	5035805/TC/M1J33/1001	17/12/07	17/12/07	17/12/07
Rev				
				A