


DO NOT SCALE

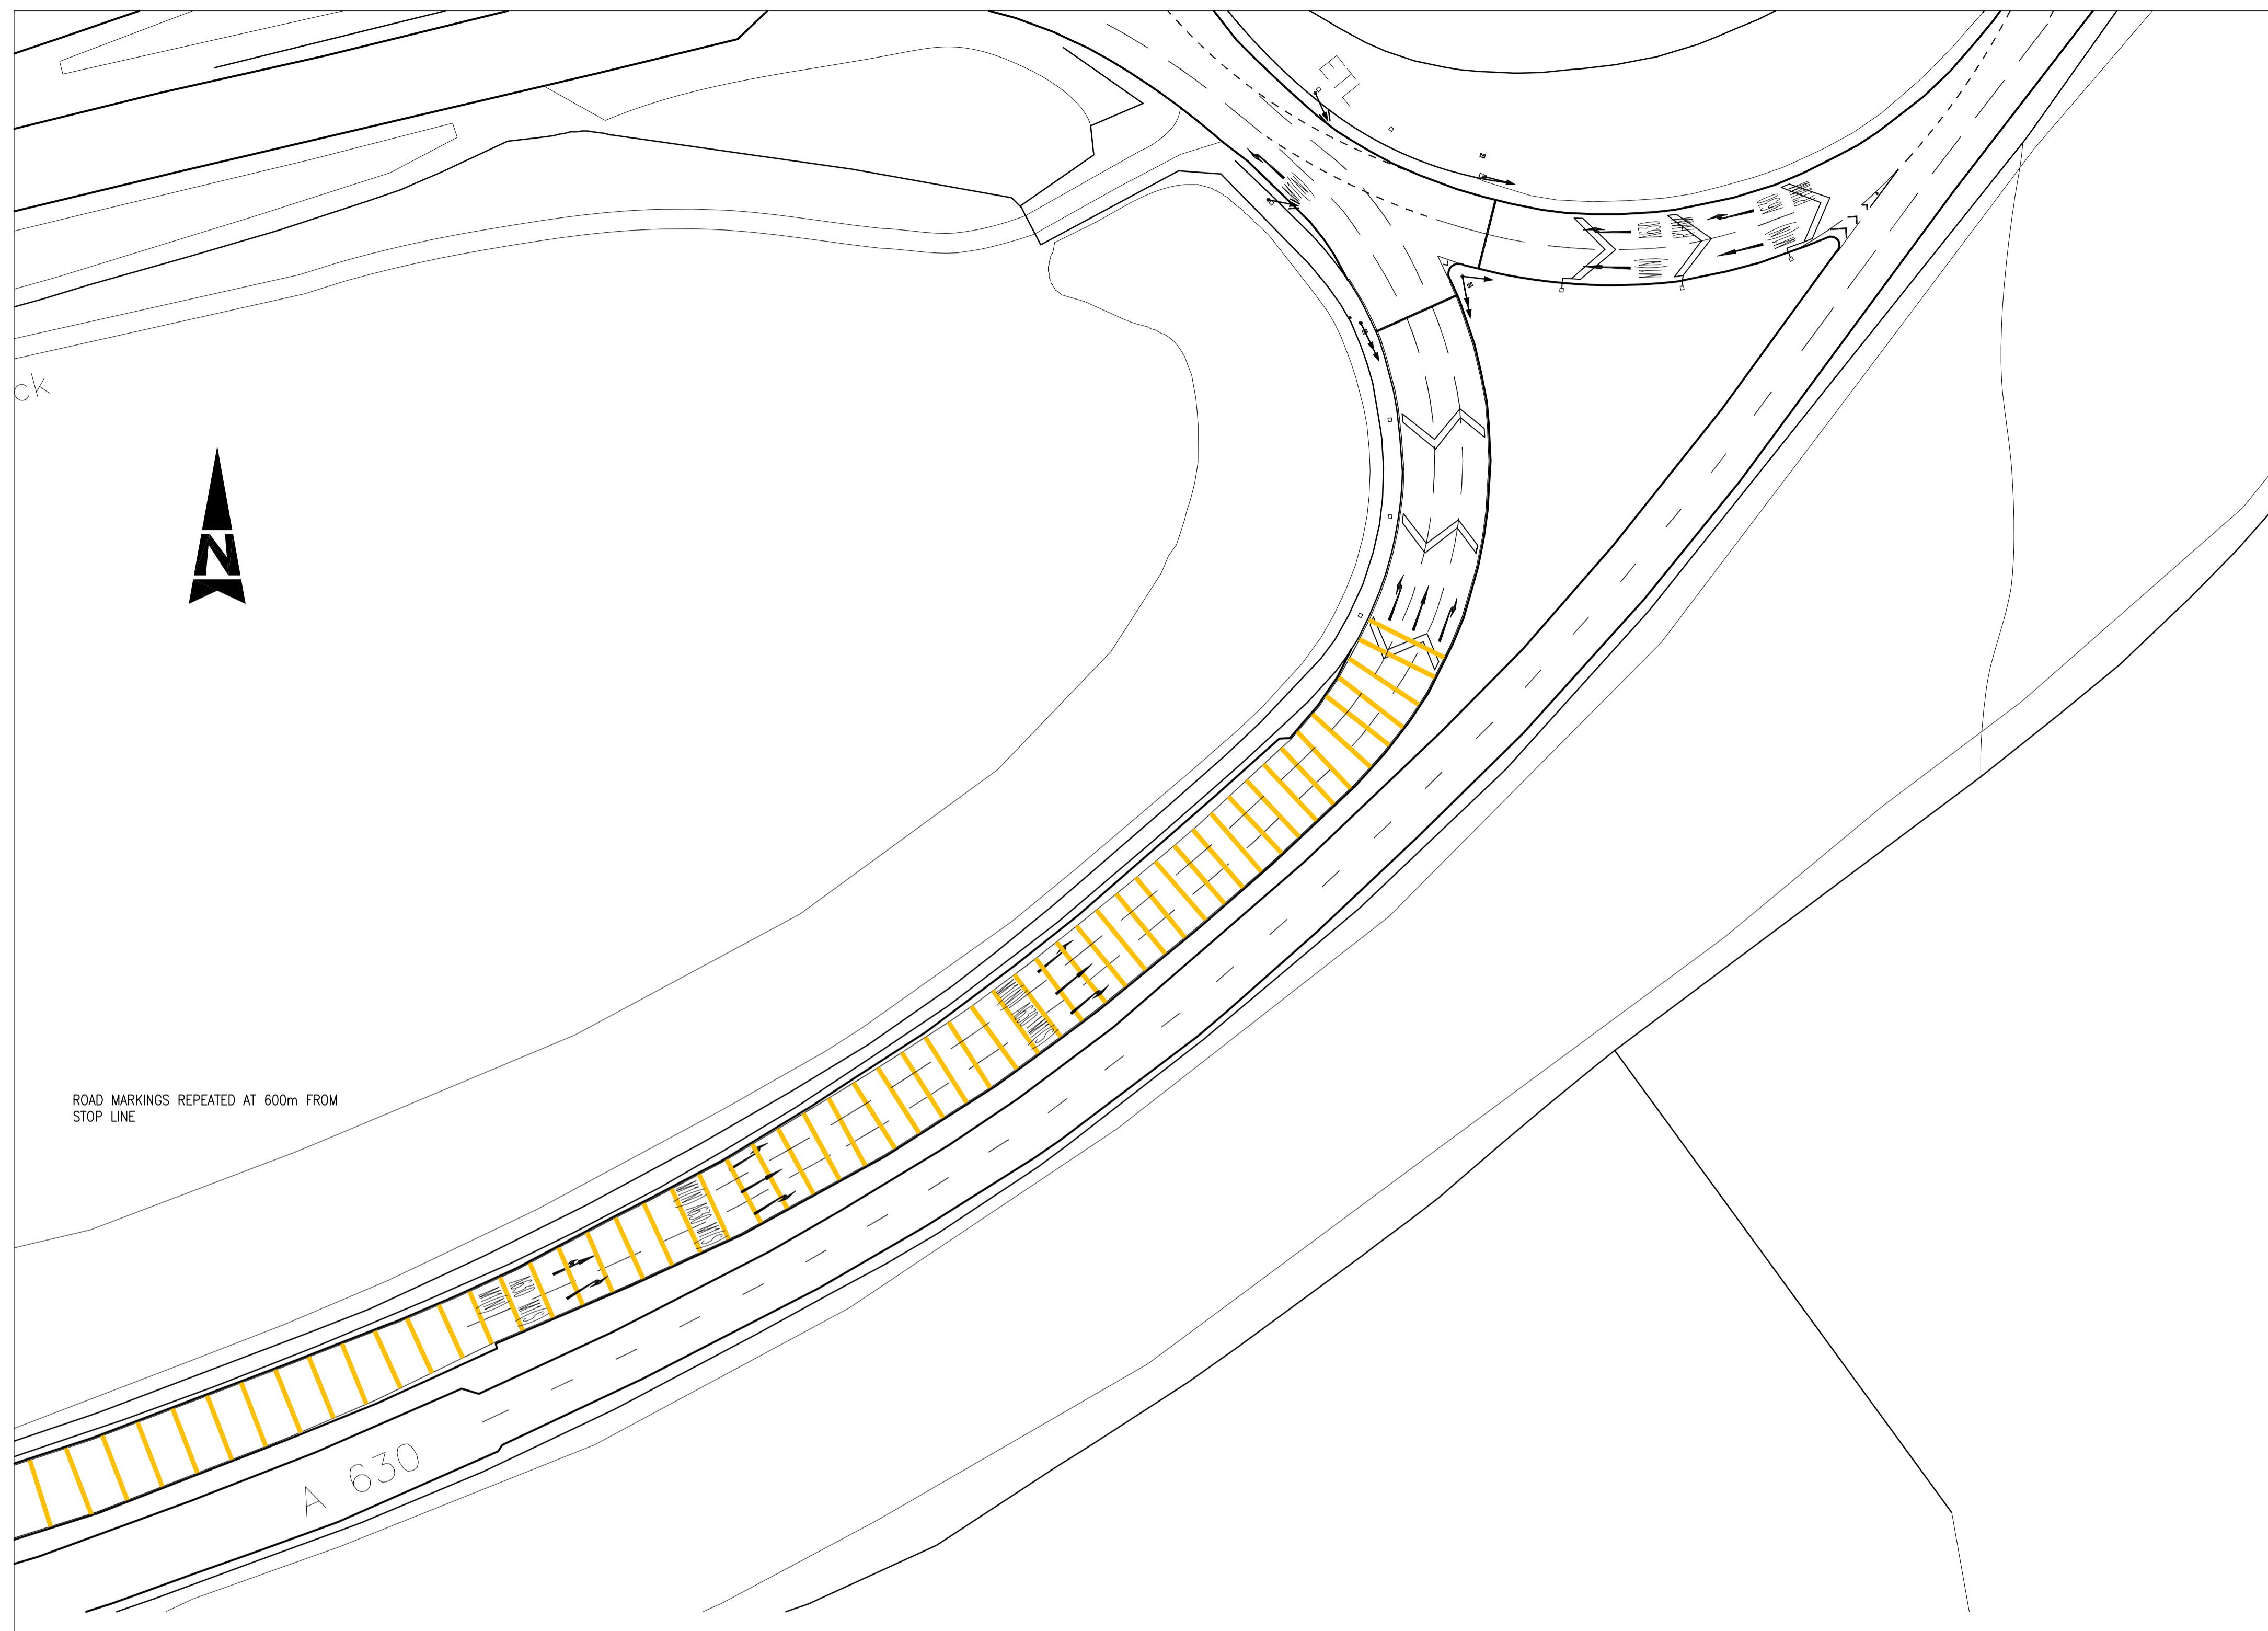

SAFETY, HEALTH AND ENVIRONMENTAL INFORMATION				
IN ADDITION TO THE HAZARDS/RISKS NORMALLY ASSOCIATED WITH THE TYPES OF WORK DETAILED ON THIS DRAWING, NOTE THE FOLLOWING SIGNIFICANT RESIDUAL RISKS				
CONSTRUCTION				
[ENTER 'NONE' IF APPLICABLE]				
MAINTENANCE/CLEANING				
[ENTER 'NONE' IF APPLICABLE]				
USE				
[ENTER 'NONE' IF APPLICABLE]				
DECOMMISSIONING/DEMOLITION				
[ENTER 'NONE' IF APPLICABLE]				
Title				
PROPOSED ROAD MARKINGS SHEET 1 OF 3				
Sheet Size	Original Scale	Designed/Drawn	Checked	Authorized
A1	1:500	DM	ADF	LS
Status	Drawing Number	Date	Date	Date
P	5035805/TC/M1J33/1001	17/12/07	17/12/07	17/12/07
Rev				Rev
				A

Atkins Limited Consulting Engineers, Threadneedle House, 9-10 Market Road, Chelmsford, Essex, England, CM1 1XA Tel: (01245) 245245 Fax: (01245) 345010 www.atkinsglobal.com		Client Project M1J33 ITM PROJECT	
Stat	Purpose of Issue	Date	Auth
A	ORIGINAL ISSUE	17/12/07	ADF
By	Date	Chk'd	Auth
DM	17/12/07	ADF	LS